



LOTS MERGED  
LOTS INTO LOTS  
16 " 20 - "1918"

REVISED '65  
" '67  
" '68  
" '71  
Revised 2000  
Revised 2003  
Revised 2004

lot1 into lots29&30 for 2000 roll  
lot3 into lots31&32 for 2003 roll  
lots29&30 into lots33&34 for 2004 roll

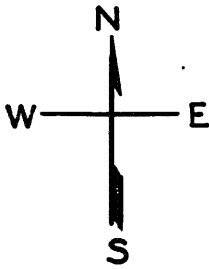

UNION

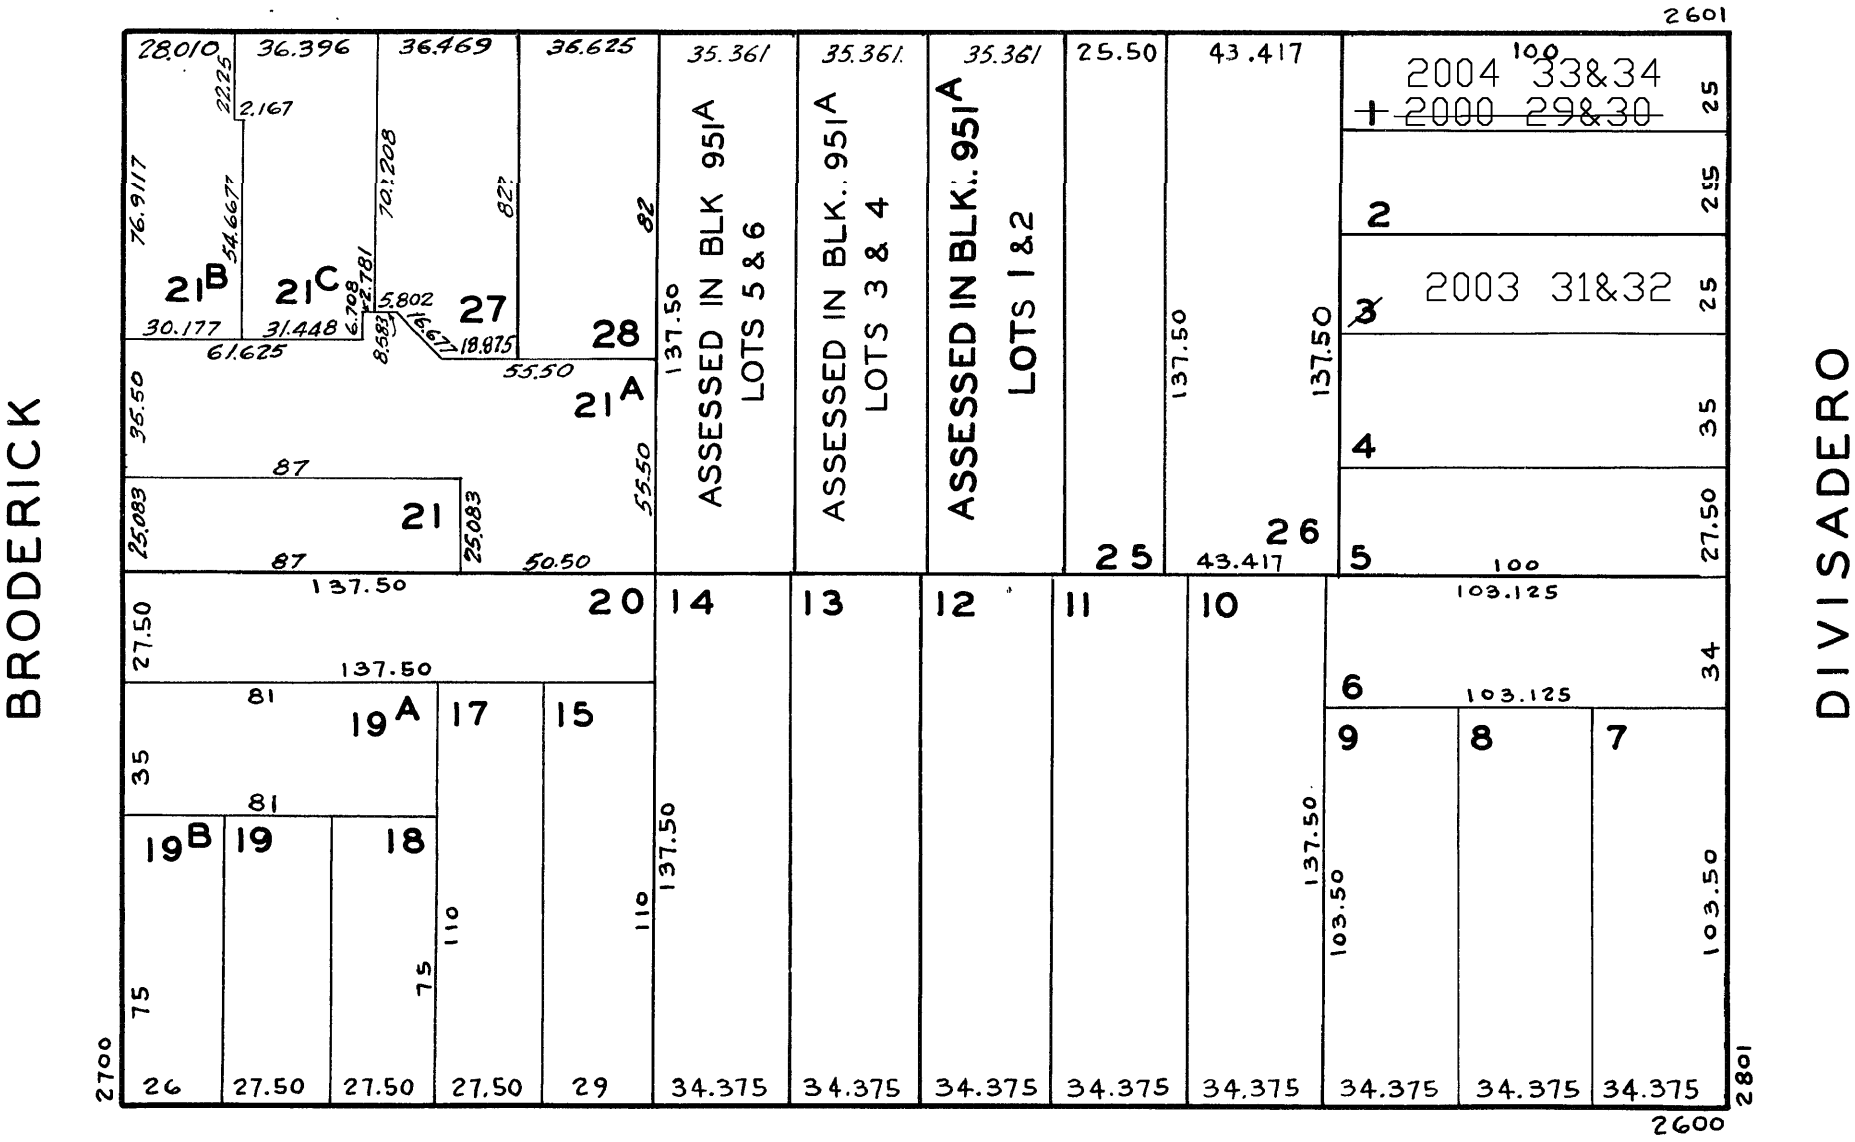

GREEN

<del>2601-2609 UNION ST.</del>			
<del>A CONDOMINIUM</del>			
<del>LOT</del>	<del>UNIT</del>	<del>% COMM. AREA</del>	
<del>29</del>	<del>2601</del>	<del>52.00</del>	
<del>30</del>	<del>2609</del>	<del>48.00</del>	

2857-2859 DIVISADERO ST.			
A CONDOMINIUM			
LOT	UNIT	% COMM. AREA	
31	2857	20	
32	2859	80	


2601-2609 UNION ST.			
A CONDOMINIUM			
LOT	UNIT	% COMM. AREA	
33	2601	75	
34	2609	25	

951A

ROSSTON TOWNHOUSES

SCALE: 1" = 20' - 0"


REVISED '67  
" '68

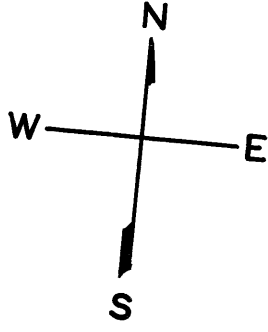

UNION

CERT. DATED 12-23-64 → 208.22'  
CERT. DATED 11-2-65 → 137.50'

BRODERICK

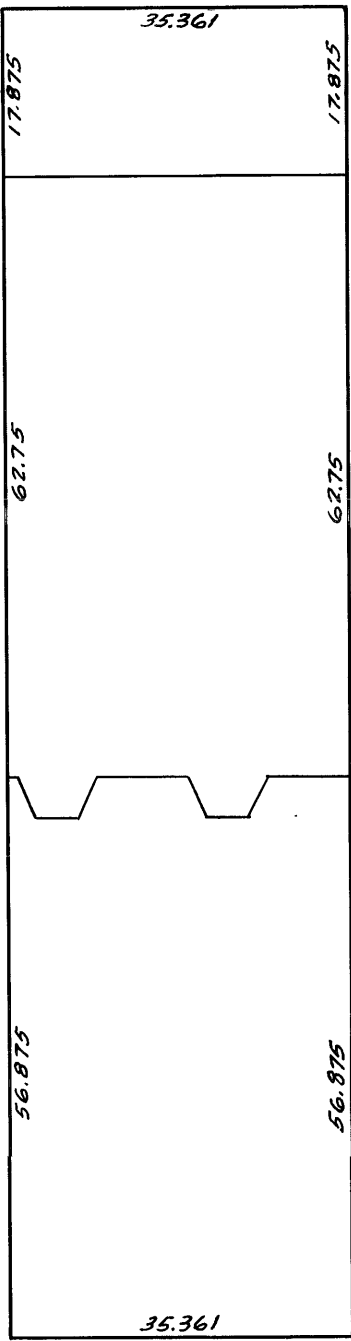


SITE MAP

CERT. DATED 12-23-64

UNIT A LOT 2 29  
UNIT B LOT 1 29


FORMERLY  
PTN LOT

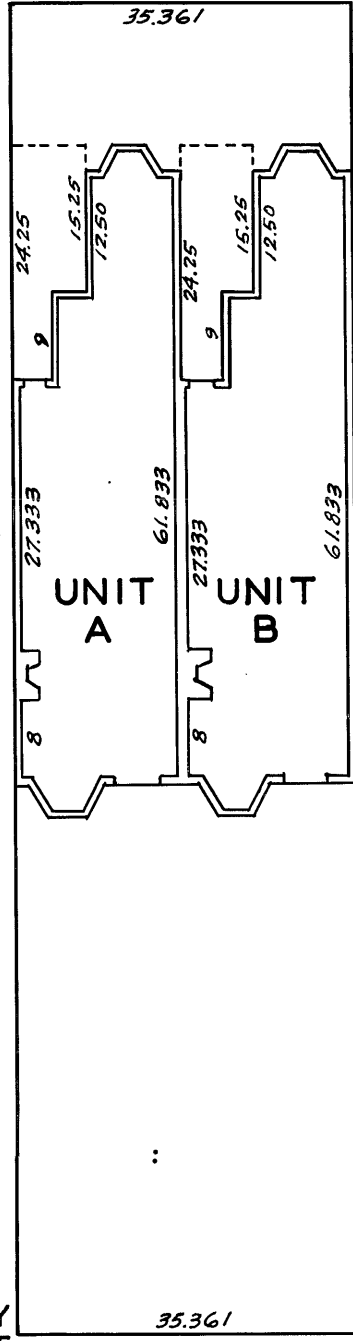

FIRST FLOOR

CERT. DATED 11-2-65 BOOK A986 PAGE 355


UNIT A LOT 4 28  
UNIT B LOT 3 28

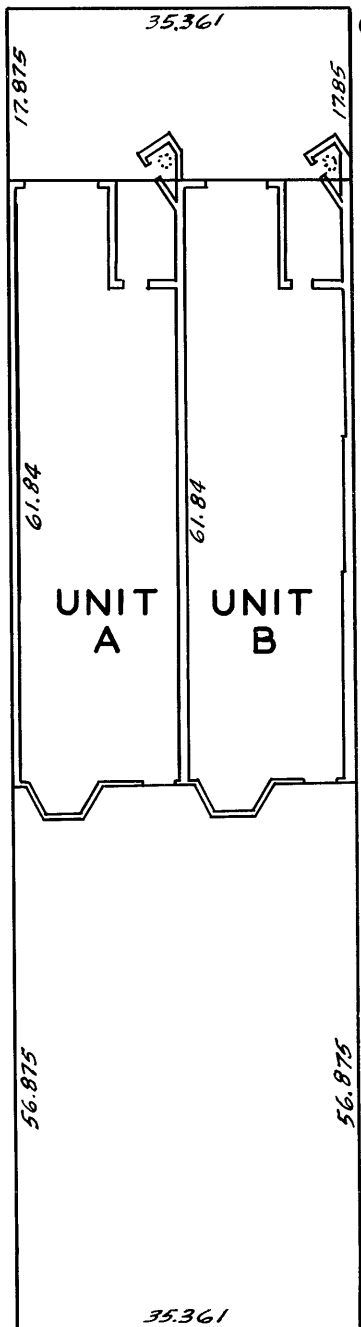

GROUND FLOOR

CERT. DATED 11-2-65

UNIT A LOT 6 27  
UNIT B LOT 5 27  
BOOK A986 PAGE 347

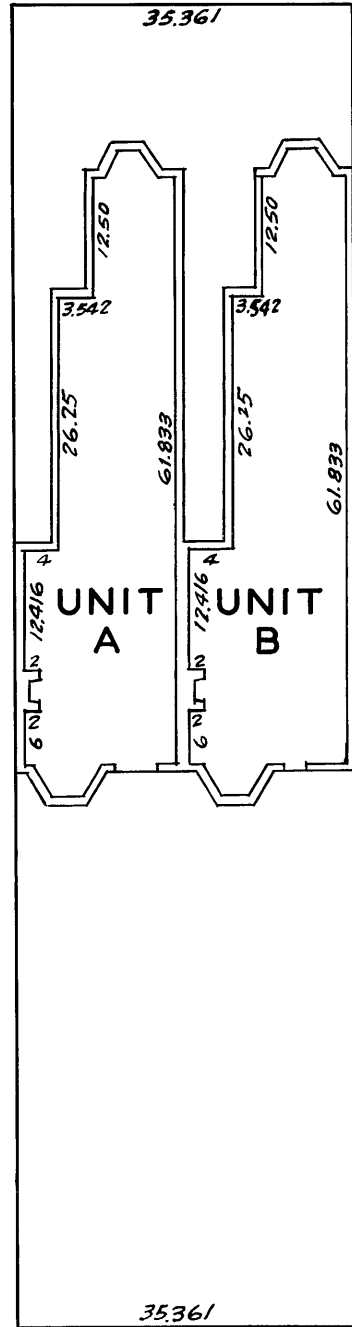

SECOND FLOOR